
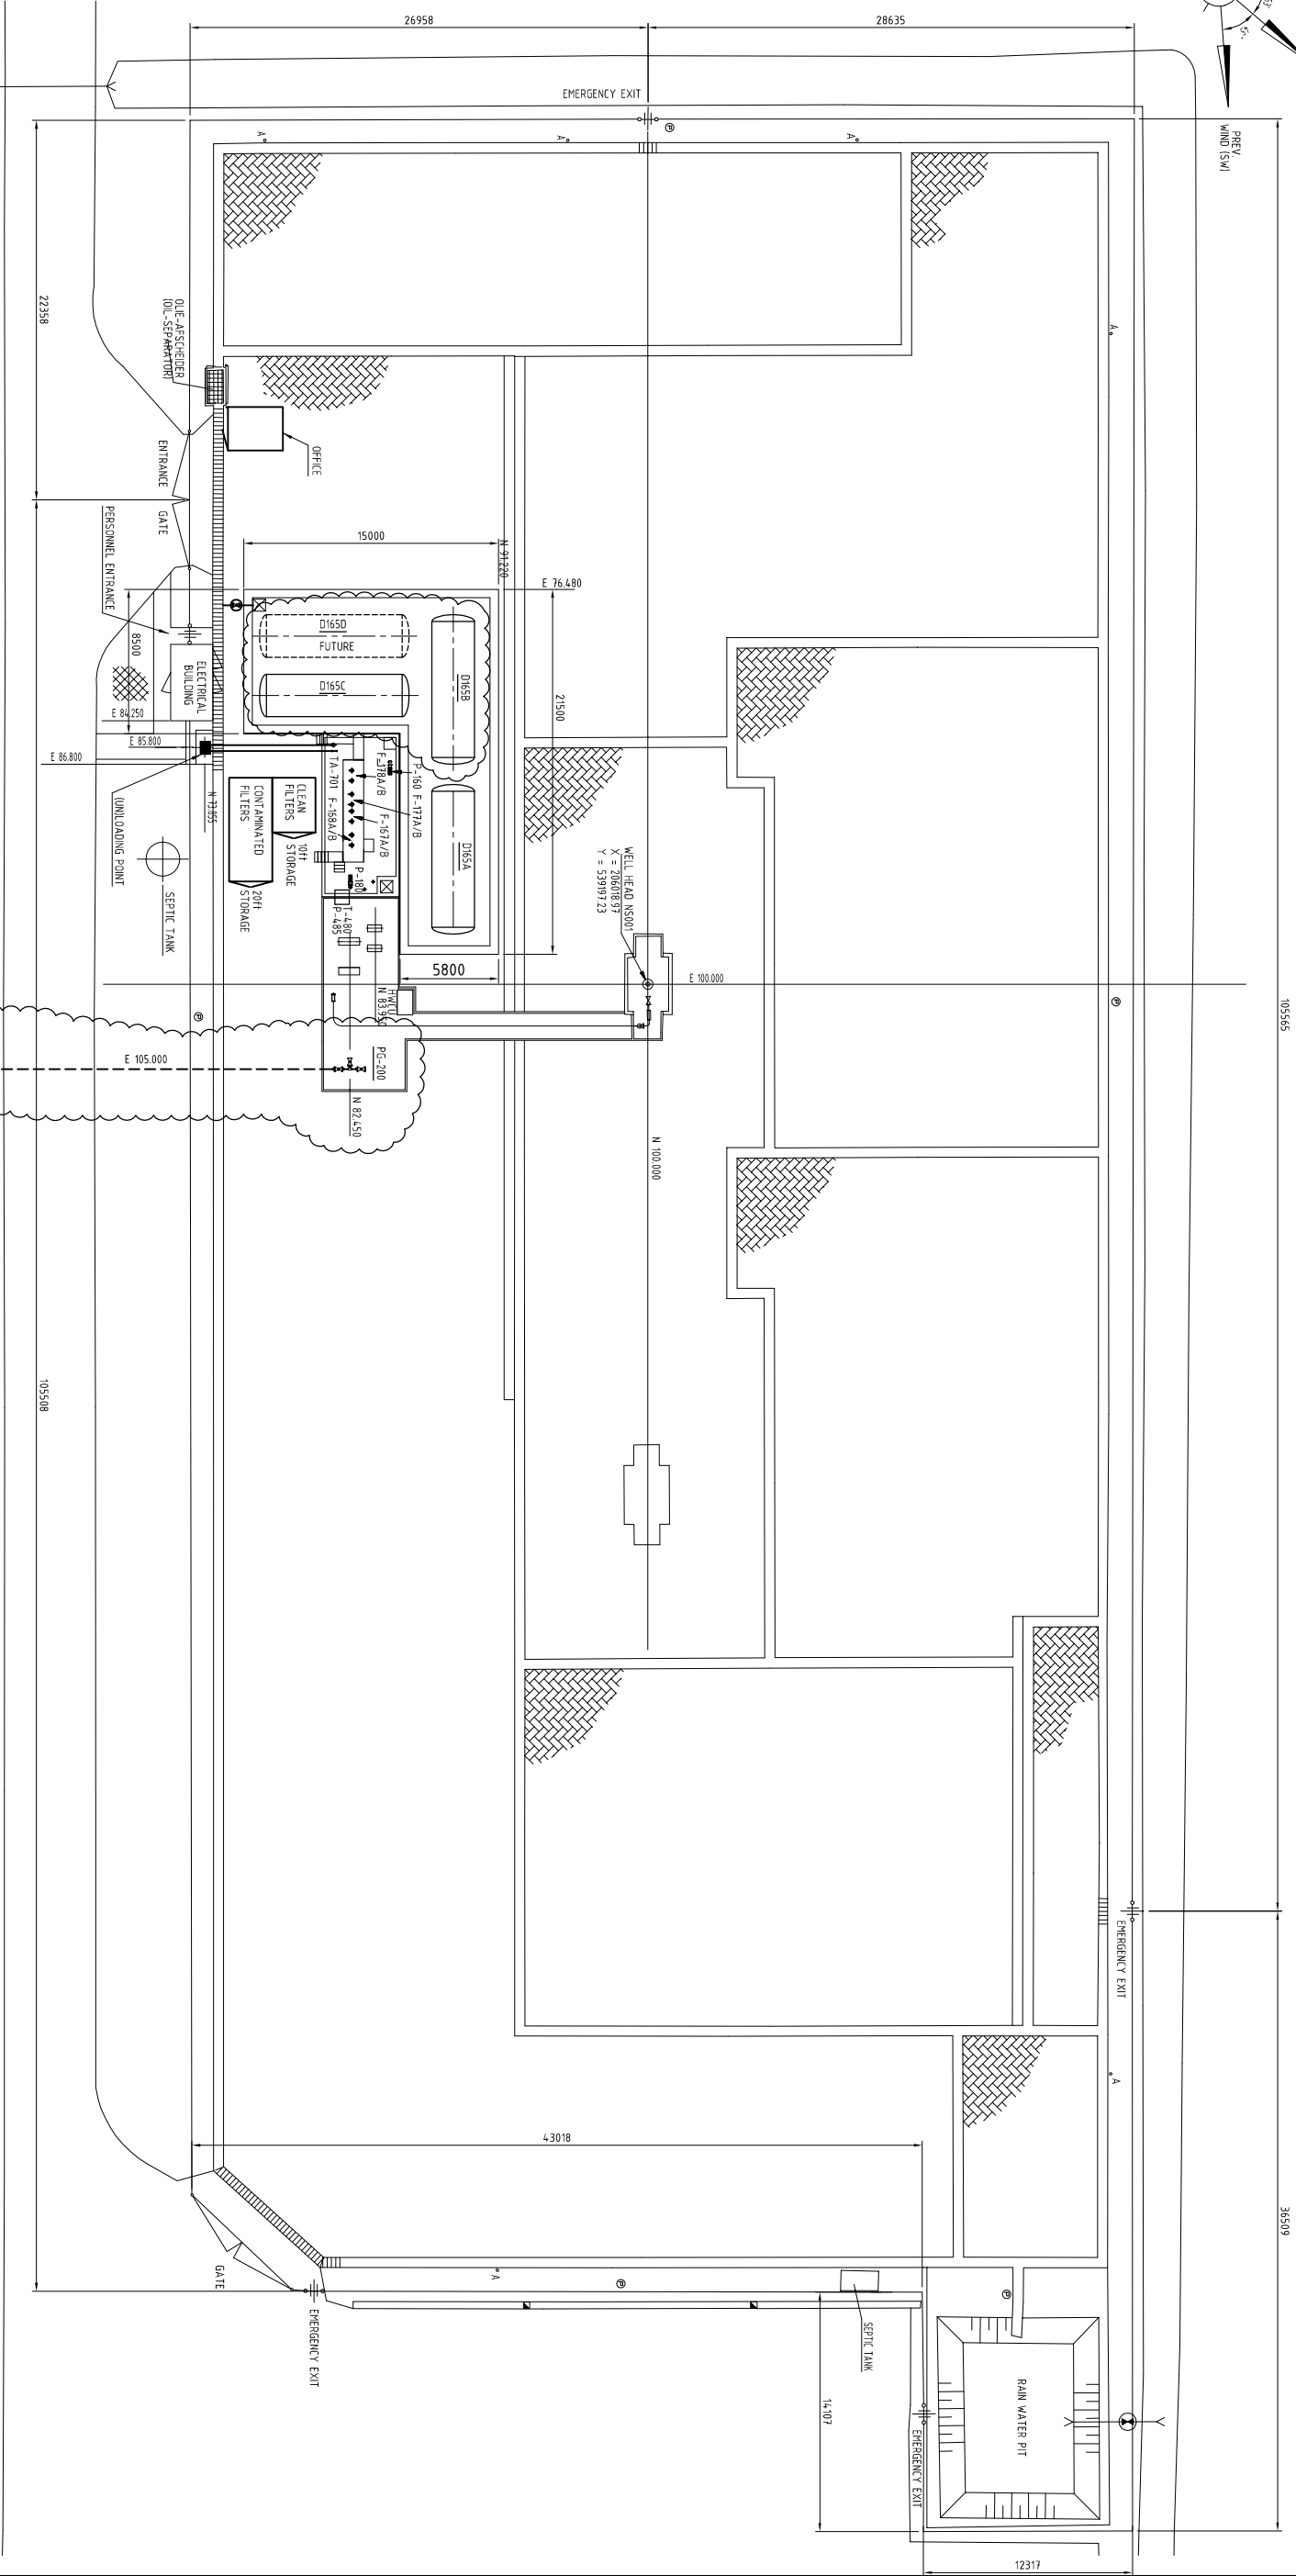


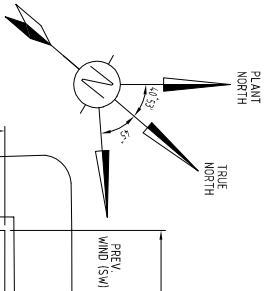

4- PIPE LINE FORMATION WATER FROM EESVEN
5- GAS TRANSFER LINE FROM EESVEN

5- GAS TRANSFER LINE TO WELLS TEL. LINDORRE

MODIFICATION FOR WATER INJECTION FROM EESVEN

For Information Only
By P. van Kampen on Dec 16, 2013
TEBODIN
Manufacturers and vendors remain responsible for the content of their documents under all circumstances.



REFERENCE DRAWINGS

NOTES

1. PEREX 401 TO BE ADDED TO TAGNUMBERS
2. ALL GUTTERS INSIDE THE "WELD GOOD" ARE PROVIDED WITH GRATING/COVERS

LEGEND

- CONCRETE
- ASPHALT
- CRUSHED STONE
- FENCE RINGING INSTALLATION
- GUTTER
- EARTHING CONNECTION
- PEZOMETER

EQUIPMENT

- D-165A/B/C/D FORMATION WATER STORAGE TANK
- UB-301 WELLHEAD CONTROL PANEL
- TA-101 FORMATION WATER PIT
- PSV-101 PRESSURE SAFETY VALVE

REV.	DATE	DESCRIPTION	DRAWN	CHECKED	APPROVED
60	16-12-2013	WATER INJECTION FROM EESVEN FOR PRESENTING			
61	09-12-2013	WATER INJECTION FROM EESVEN FOR COMMENTS			
62	13-01-2014	AS BUILT, ADDED CONTAINERS AND BORDERS			
5	01-06-2014	AS BUILT			
4-2	12-05-2010	RELEASED FOR CONSTRUCTION			
4	14-03-2008	VERGUNNINGAANVRAAG			
3	01-12-2008	AS BUILT			
2	10-03-2008	APPROVED FOR CONSTRUCTION			
1	14-12-1999	CALL FOR BID			
0	13-10-1998	FINAL ISSUE			

LOCATION	NIJENSLEEK			WELLS	NS001		
TITLE	PLOTPLAN			SCALE	1:200		
REF. No.	-			SIZE	A1		
DATE	-			DRAWING NUMBER	1-34-NS001-3-32-100		
DATE	-			SHEET	001		