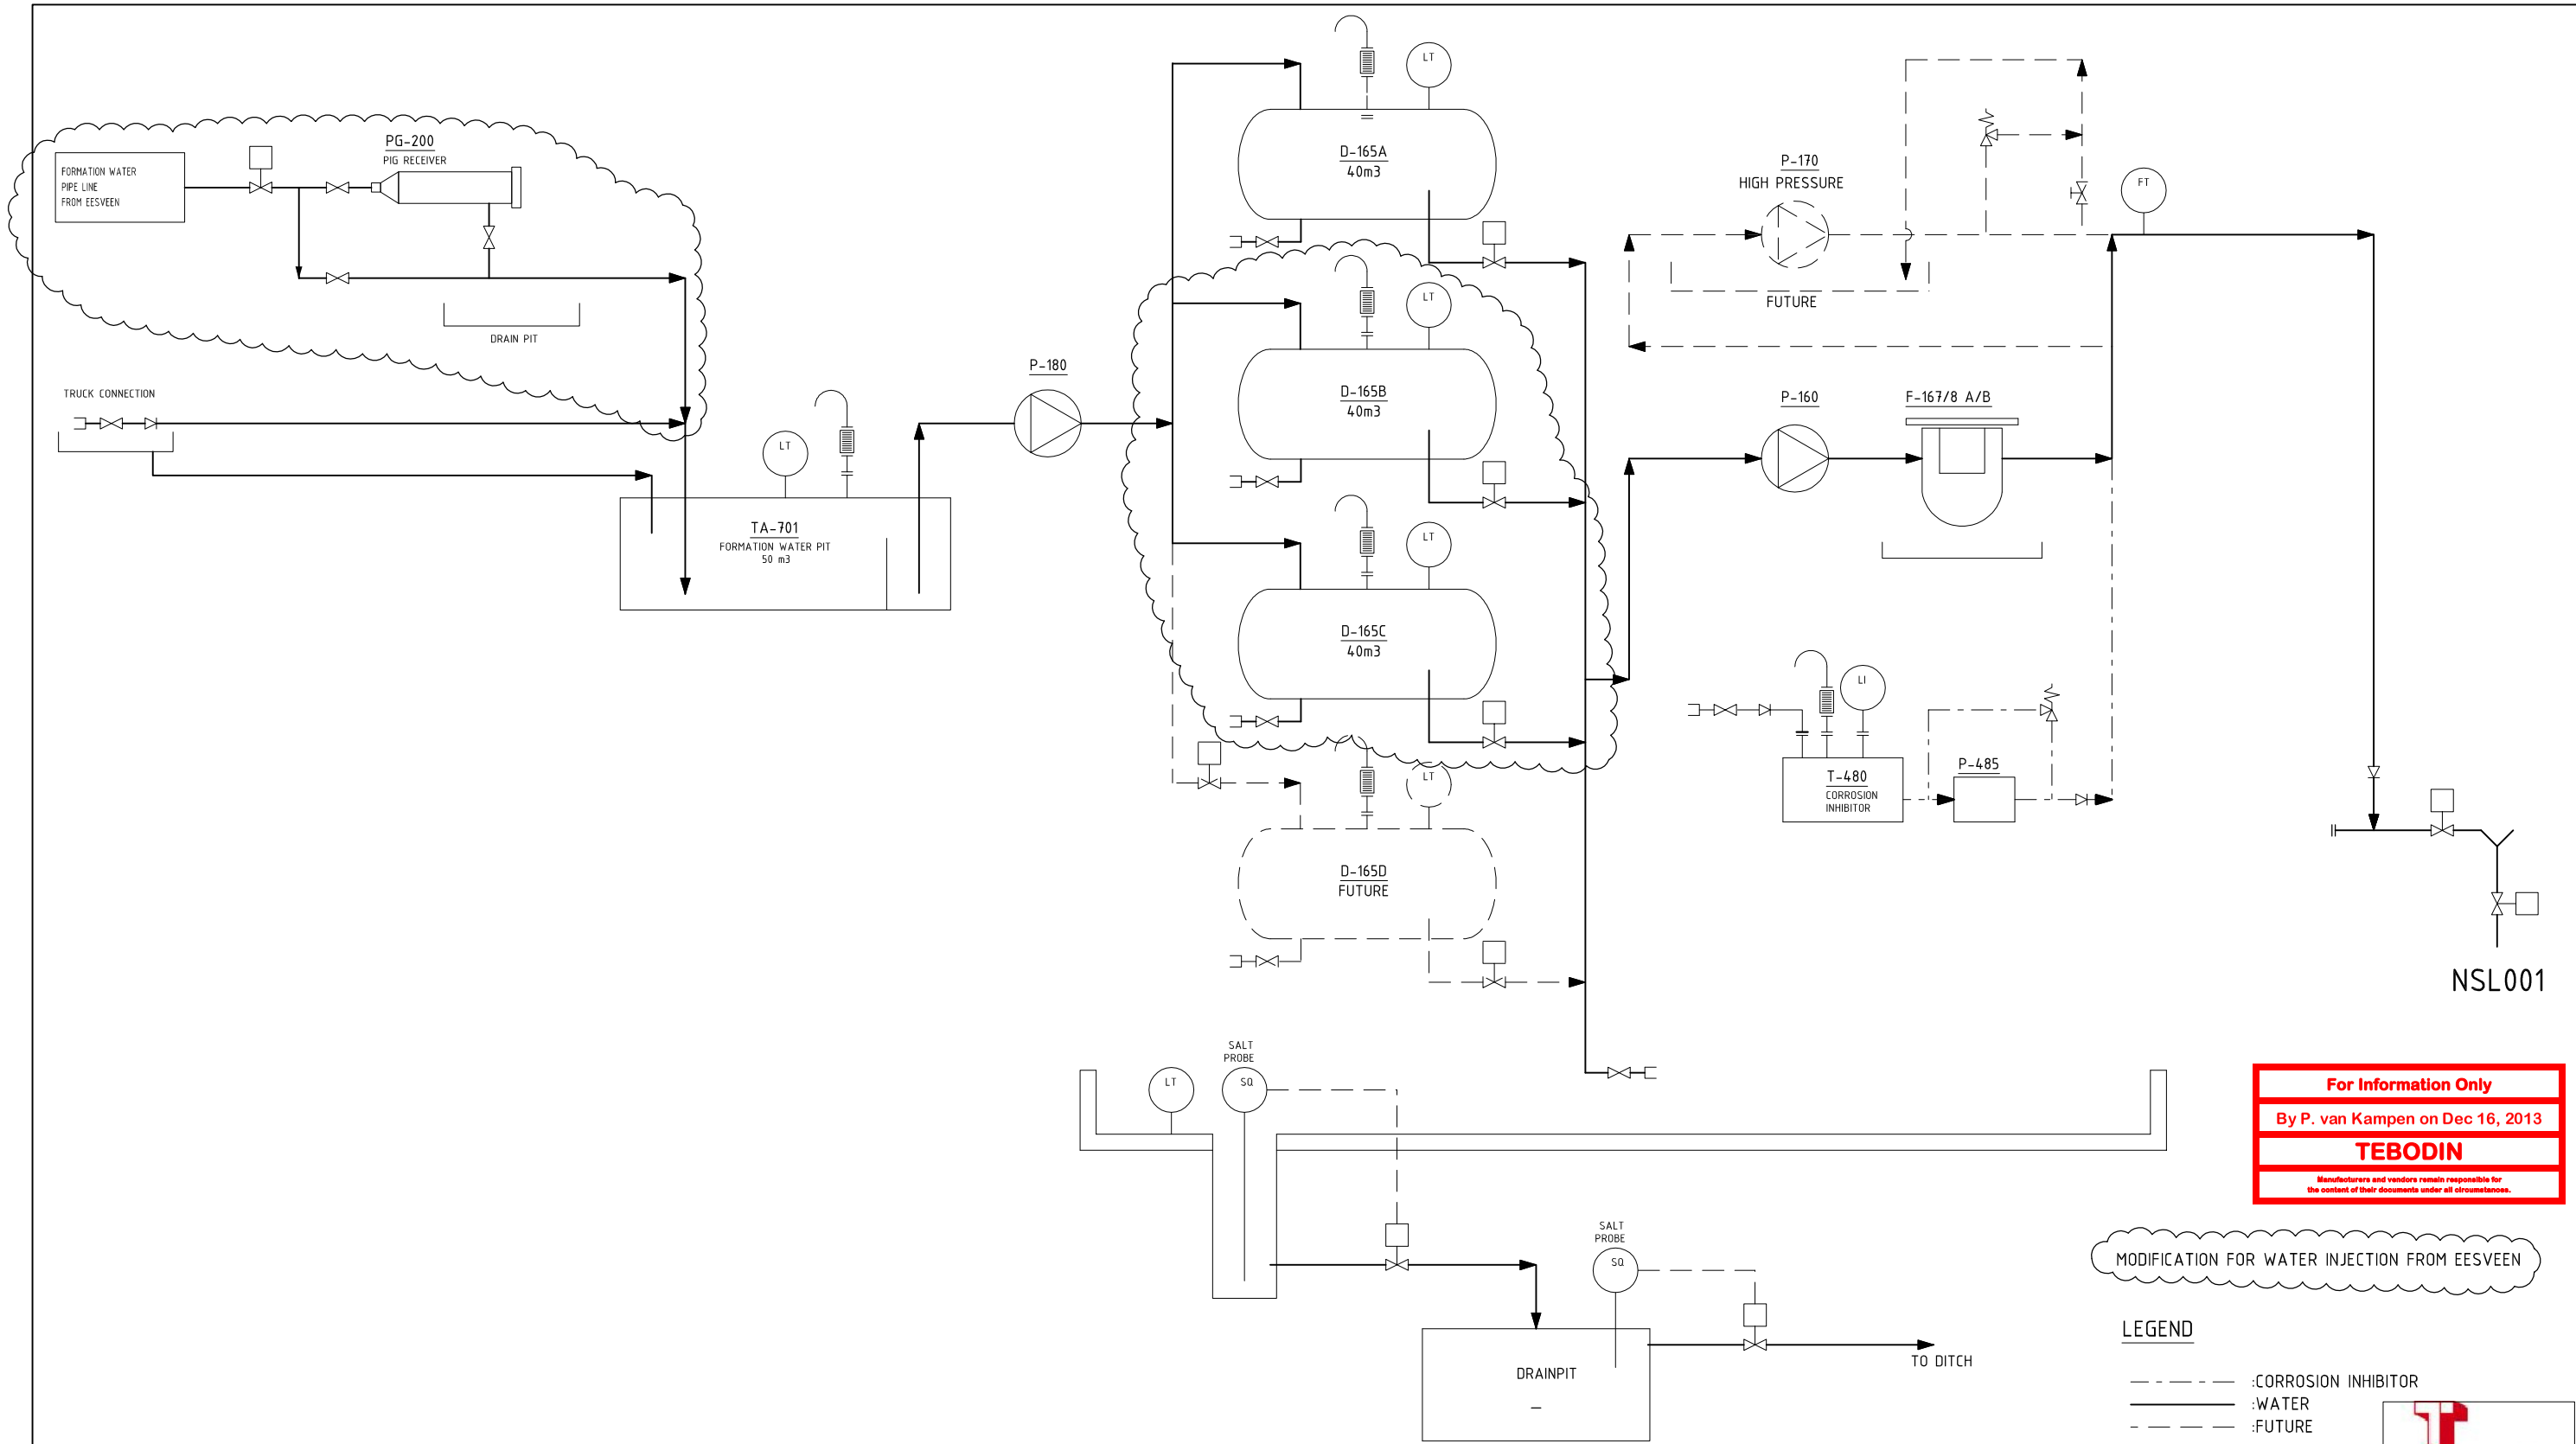

For Information Only
By P. van Kampen on Dec 16, 2013
TEBODIN
Manufacturers and vendors remain responsible for the content of their documents under all circumstances.

TEBODIN Consultants & Engineers always close

OPMERKINGEN
1-

REV.	DATE	DESCRIPTION	DRWN	CHK'D	APPR.
6A	09-12-2013	WATER INJECTION FROM EESVEEN, FOR COMMENTS			
6	01-04-2011	AS BUILT NIJENSLEEK WATER INJECTION			
5A	28-04-2010	RFC NIJENSLEEK WATERINJECTIE			
5	04-03-2009	VERGUNNINGSAANVRAAG			
4	12-05-2006	NEW BOOSTER COMPRESSOR			
3	0-04-2006	NEW BOOSTER COMPRESSOR			
2	01-12-2000	AS BUILT			
6B	16-12-2013	WATERINJECTION FROM EESVEEN, FOR PERMITTING			
0	21-10-1998	FINAL ISSUE			

LOCATION: WELLSITE NIJENSLEEK-1
WELLS: NS001

VERMILION ENERGY

TITLE:
PROCESS FLOW DIAGRAM

REF. No.:	CAD No.:
-	-

SCALE:	SIZE	DRAWING NUMBER:	SHEET:
NONE	A2	1-34-NS001-3-31-104-001	001